



Fire Systems West
 600 SE Maritime Avenue, Suite
 Vancouver, WA 98661
 (360) 693-9906 fax: (503) 281-1089

WA CONTR. LIC. REC. CMB-143-01 • OR CONTR. LIC. REC. 4723 • P.O. BOX 50 • 97133-0050

SPRINKLER SYMBOL DESCRIPTION

SYMBOL	TYPE	WET	WDR	DRY	TOP	FRSH	CHNGP	TOTAL
TOTAL SPRINKLERS SHOWN ON THIS SHEET								
HANGER LEGEND								
1	1" TYP. HOSE							
2	2" DAMN BUCK EXHAUST							
3	2" TYP. CLAMP							
4	2" TYP. HOSE CLAMP							
5	2" HOSE WRENCH							
6	2" HOSE WRENCH							
APPROVALS REQUIRED	DISTRIBUTION
DESIGNED BY	ENGINEER/ARCHITECT
CHECKED BY	CITY OF PORTLAND
DATE	
TOTAL	

GENERAL NOTES

- ALL MATERIAL AND EQUIPMENT TO BE USED AND INSTALLATION APPROVED BY THE CITY OF PORTLAND.
- SPRINKLER SYSTEM SHALL BE INSTALLED IN ACCORDANCE WITH THE CITY OF PORTLAND FIRE DEPARTMENT SPECIFICATIONS.
- SPRINKLER SYSTEM SHALL BE INSTALLED IN ACCORDANCE WITH THE CITY OF PORTLAND FIRE DEPARTMENT SPECIFICATIONS.
DESIGN CRITERIA AND NOTES

- BUILDING AREA - RESIDENTIAL UNITS**
 - RESIDENTIAL UNITS SHALL BE INSTALLED IN ACCORDANCE WITH THE CITY OF PORTLAND FIRE DEPARTMENT SPECIFICATIONS.
 - RESIDENTIAL UNITS SHALL BE INSTALLED IN ACCORDANCE WITH THE CITY OF PORTLAND FIRE DEPARTMENT SPECIFICATIONS.
- BUILDING AREA - COMMON AREAS**
 - RESIDENTIAL UNITS SHALL BE INSTALLED IN ACCORDANCE WITH THE CITY OF PORTLAND FIRE DEPARTMENT SPECIFICATIONS.
 - RESIDENTIAL UNITS SHALL BE INSTALLED IN ACCORDANCE WITH THE CITY OF PORTLAND FIRE DEPARTMENT SPECIFICATIONS.
- BUILDING AREA - PARKING GARAGE, MECHANICAL AND ELECTRICAL ROOMS**
 - RESIDENTIAL UNITS SHALL BE INSTALLED IN ACCORDANCE WITH THE CITY OF PORTLAND FIRE DEPARTMENT SPECIFICATIONS.
 - RESIDENTIAL UNITS SHALL BE INSTALLED IN ACCORDANCE WITH THE CITY OF PORTLAND FIRE DEPARTMENT SPECIFICATIONS.
- BUILDING AREA - MECHANICAL, MECHANICAL AND ELECTRICAL ROOMS**
 - RESIDENTIAL UNITS SHALL BE INSTALLED IN ACCORDANCE WITH THE CITY OF PORTLAND FIRE DEPARTMENT SPECIFICATIONS.
 - RESIDENTIAL UNITS SHALL BE INSTALLED IN ACCORDANCE WITH THE CITY OF PORTLAND FIRE DEPARTMENT SPECIFICATIONS.
NOTES

- SPRINKLER SYSTEM SHALL BE INSTALLED IN ACCORDANCE WITH THE CITY OF PORTLAND FIRE DEPARTMENT SPECIFICATIONS.
- SPRINKLER SYSTEM SHALL BE INSTALLED IN ACCORDANCE WITH THE CITY OF PORTLAND FIRE DEPARTMENT SPECIFICATIONS.
REVISIONS

NO.	DESCRIPTION	DATE
1	PER ARCHITECT REVIEW COMMENTS	11-14-05
2	PER LISTING	11-14-05

AS BUILT

NO. _____ DATE _____



DESCRIPTION _____

THE VAUX
 1600 N.W. 24th AVENUE
 PORTLAND, OREGON 97210
 5th FLOOR - PORTLAND, OREGON
 JOB SITE: PORTLAND, OREGON
 JOB SITE: PORTLAND, OREGON
 JOB SITE: PORTLAND, OREGON

CONTRACT WITH:
TRAMMELL CROW RESIDENTIAL
 830 NW 10TH AVE
 PORTLAND, OR 97209
 PHONE: 503-241-5537
 FAX: 503-241-5462

DWG. TITLE:
 COMBO FLOOR CONTROL & STANDPIPE STAIR 177 (BLDG A)
 COMBO FLOOR CONTROL & STANDPIPE STAIR 173 (BLDG A)
 COMBO FLOOR CONTROL & STANDPIPE STAIR 176 (BLDG B)
 COMBO FLOOR CONTROL & STANDPIPE STAIR 162 (BLDG B)

DESIGNER: DATE: JOB NO.: SHEET: 11-14-05 11-14-05 11-14-05 11-14-05

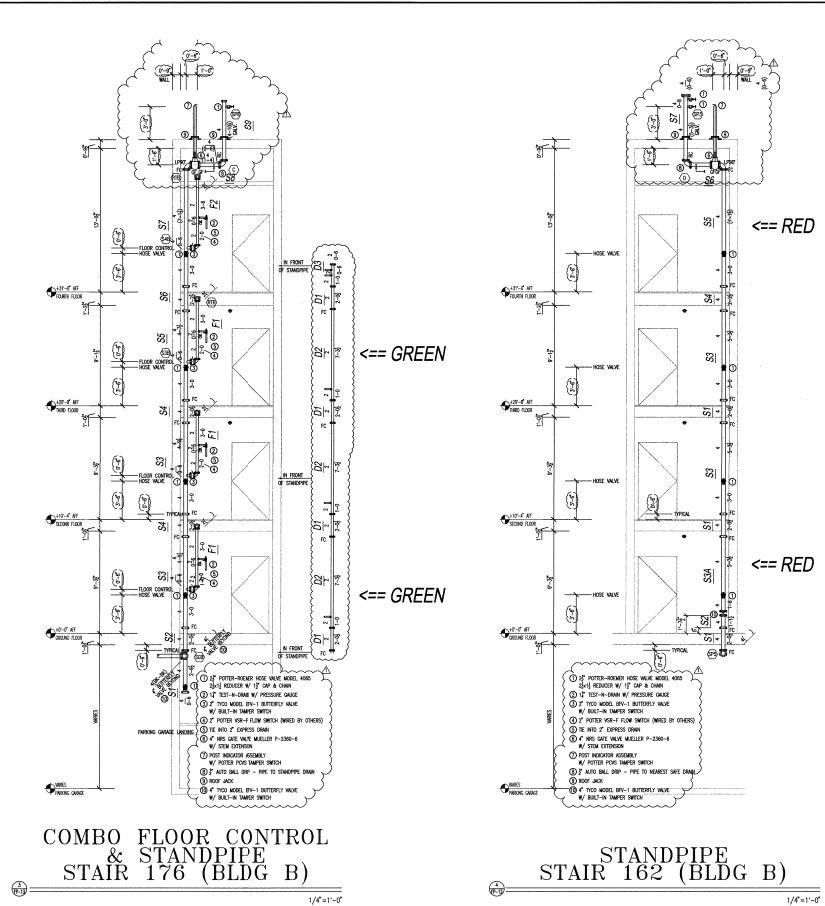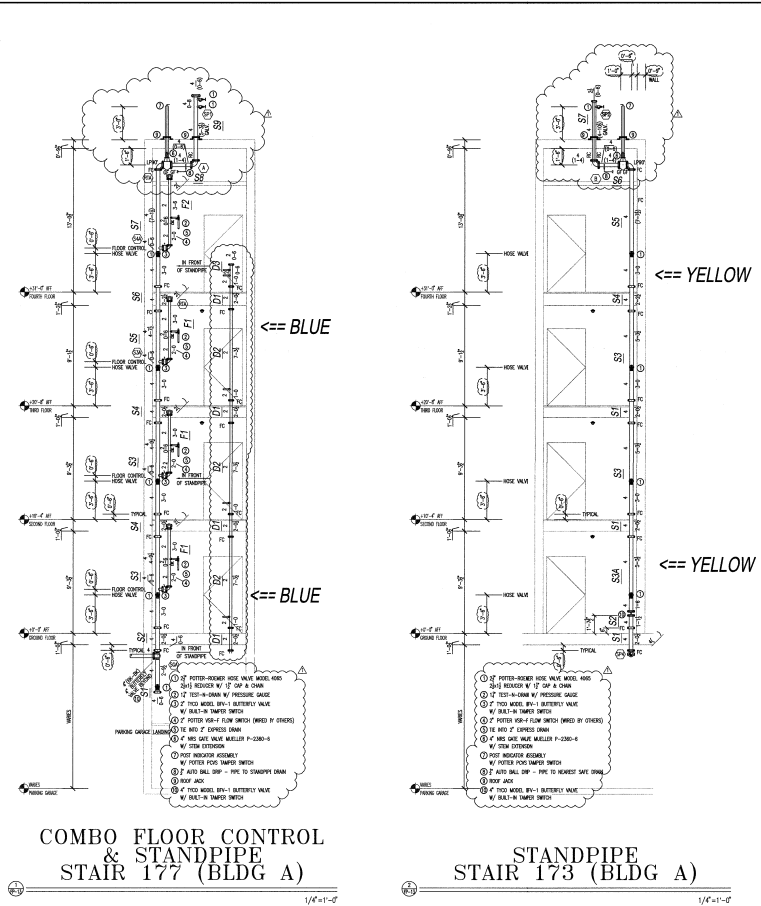

REVISIONS

NO.	DESCRIPTION	DATE
1	PER ARCHITECT REVIEW COMMENTS	11-14-05
2	PER LISTING	11-14-05

AS BUILT

NO. _____ DATE _____

DESCRIPTION _____

THE VAUX
 1600 N.W. 24th AVENUE
 PORTLAND, OREGON 97210
 5th FLOOR - PORTLAND, OREGON
 JOB SITE: PORTLAND, OREGON
 JOB SITE: PORTLAND, OREGON
 JOB SITE: PORTLAND, OREGON

CONTRACT WITH:
TRAMMELL CROW RESIDENTIAL
 830 NW 10TH AVE
 PORTLAND, OR 97209
 PHONE: 503-241-5537
 FAX: 503-241-5462

DWG. TITLE:
 COMBO FLOOR CONTROL & STANDPIPE STAIR 177 (BLDG A)
 COMBO FLOOR CONTROL & STANDPIPE STAIR 173 (BLDG A)
 COMBO FLOOR CONTROL & STANDPIPE STAIR 176 (BLDG B)
 COMBO FLOOR CONTROL & STANDPIPE STAIR 162 (BLDG B)

DESIGNER: DATE: JOB NO.: SHEET: 11-14-05 11-14-05 11-14-05 11-14-05