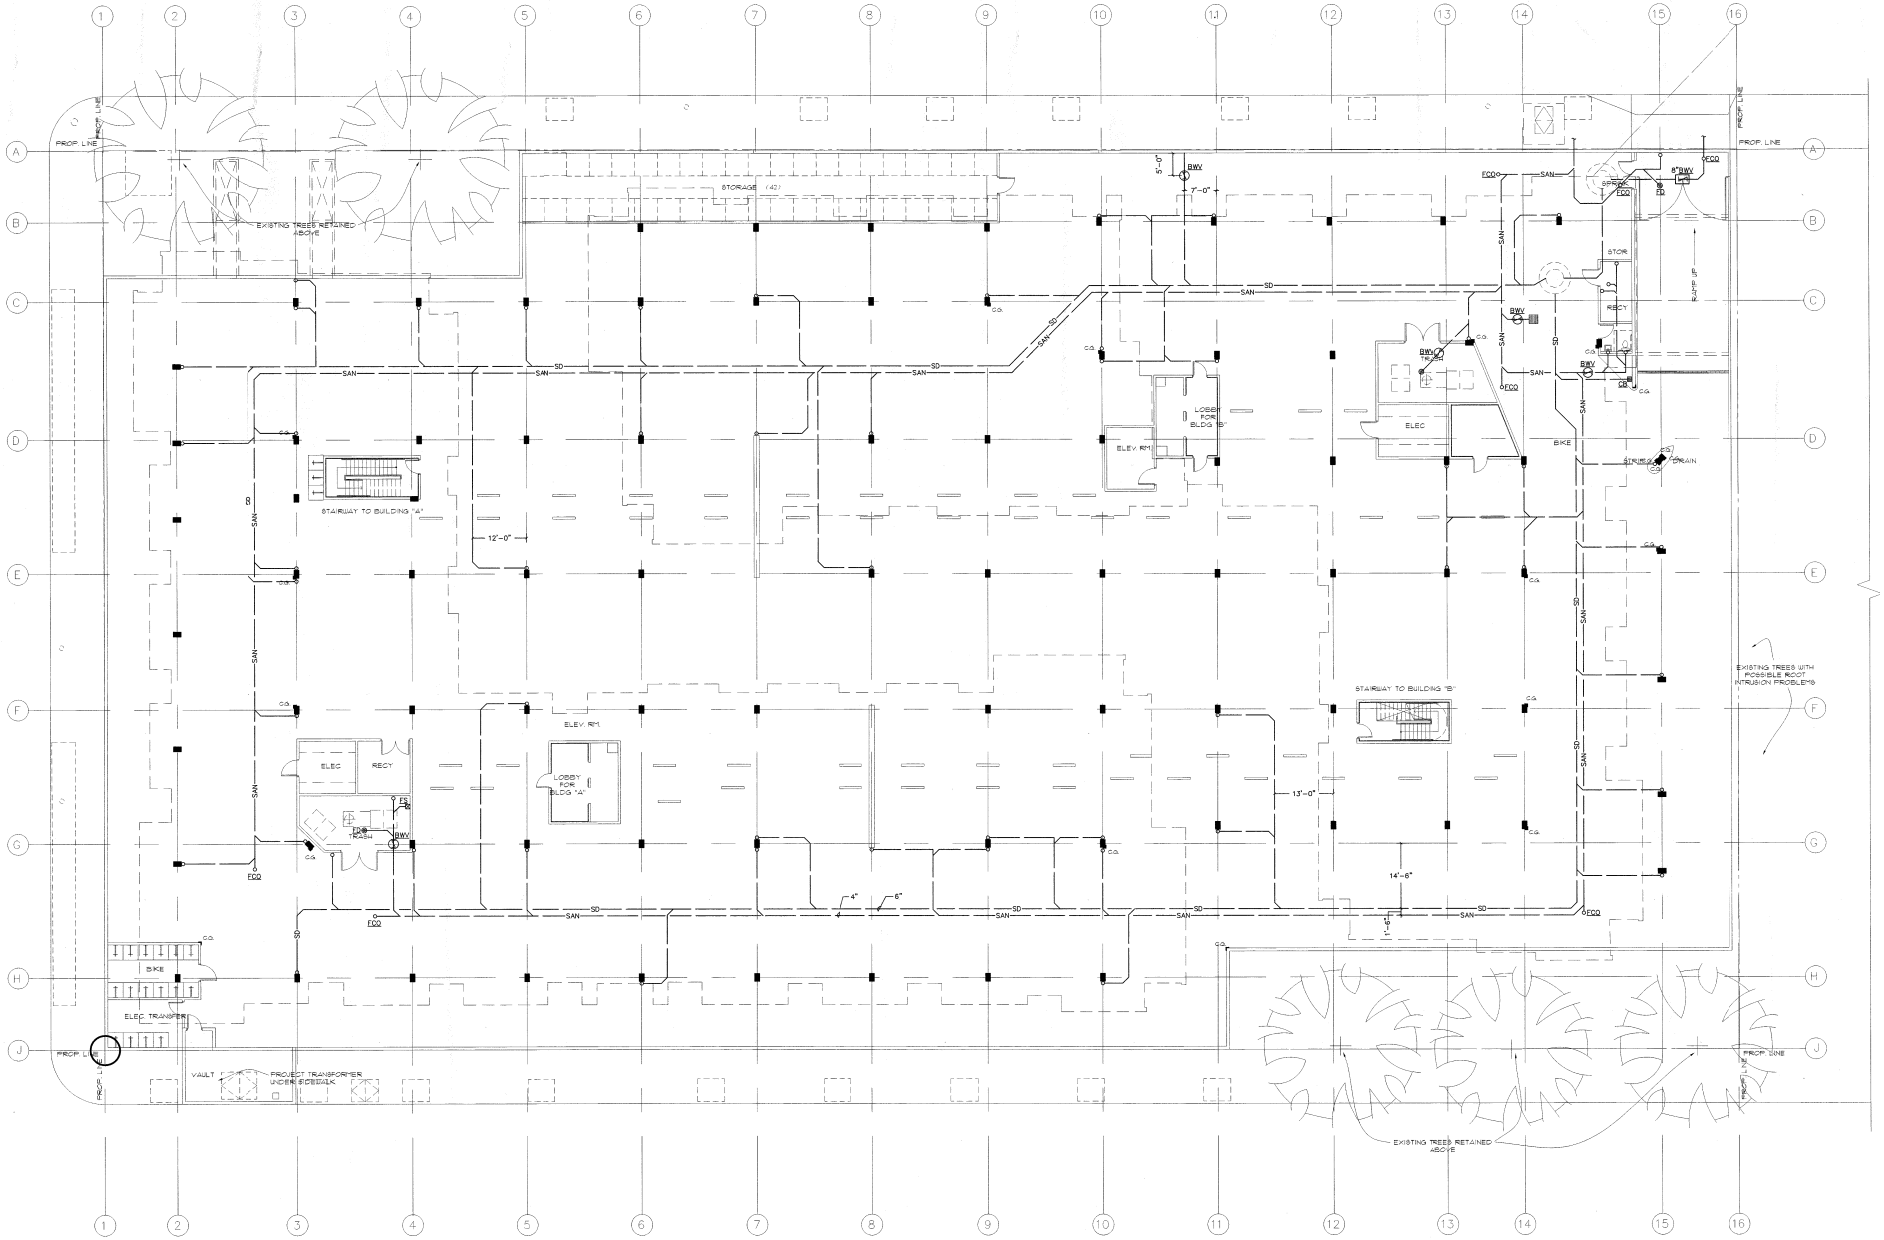

1 BASEMENT PLAN
P2.0
3/32"=1'-0"

1 AS BUILT BY PENINSULA PLUMBING

ANKROM MOISAN ARCHITECTURE INTERIORS PLANNING
6720 SW MACADAM, SUITE 100, PORTLAND, OREGON 97219
PHONE 503-245-7100 FAX 503-245-7111 WWW.AMA.COM

TCR – THE VAUX

TRAMMELL CROW RESIDENTIAL

MARK	DATE

DATE: 01.10.05
JOB: 041100
FILE: X-ITB-34X44
DRAWN: CF
CHECKED: CG

BASEMENT PLAN

P2.0